


LABOR AND MATERIALS

1	Copper Lead	Connection	3/4	\$
1	Curb	Cock Valve T.S. & V.	1" in.	\$
1	Service box Old returned	Short 3 1/2 x 4 1/2 } Long 4 1/2 x 5 1/2 }		\$
16	Pt. 1" in.	Copper G. I. C.T. } Pipe at		\$
	Nipples	in. at		\$
1	Bushings	1" to 1/2" in. at		\$
	Red'g Inc'g } Coupl'gs	to in. at		\$
	Union	in. at		\$
	Meter	in. at		\$
	Compound Joints	at		\$
	Maintenance Foreman			\$
	Hrs. Water Maint. Man-1	at		\$
	Hrs. Water Maint. Man-2	at		\$
	Hrs. Garage Foreman	at		\$
	Hrs. Labor	at		\$
	Hrs. Compressor	at		\$
	Trucking			\$
	Pav't Patch			\$
				\$
				\$
St. CRANDALL  
 Ave. No. 20

Name of Owner \_\_\_\_\_

Labor and Mat'l. Report SEPT 27 1924

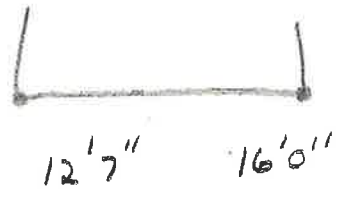

● Curb Box

8" Main                      Elev. of Main at tap 4'

Gate at ●    ● Gate at

● Curb Box