

LABOR AND MATERIALS

1	Copper	Connection	\$
	Lead		
1	Curb	Cock Valve T. S. & V. } in.	\$
1	Service box	Short 3 1/2 x 4 1/2 }	
	Old returned	Long 4 1/2 x 5 1/2 }	\$
11	Ft. 1"	Copper } Pipe at	\$
		G. I. }	
		C. I. }	
	Nipples	in. at	\$
	Bushings	to in. at	\$
	Red'g		
	Inc'g	Coupl'gs to in. at	\$
	Union	in. at	\$
	Meter	in. at	\$
			\$
	Compound Joints	at	\$
	Maintenance Foreman		\$
	Hrs. Water Maint. Man—1	at	\$
	Hrs. Water Maint. Man—2	at	\$
	Hrs. Garage Foreman	at	\$
	Hrs. Labor	at	\$
	Hrs. Compressor	at	\$
			\$
	Trucking		\$
	Pav't Patch		\$
			\$
			\$
			\$
			\$


CRANDALL

St. Pt. Ave. No. 21

Name of Owner

Labor and Mat'l. Report

JULY 2 19 24

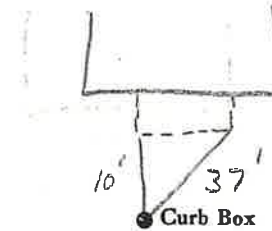

DIVISION ST.

CRANDALL ST

Main

Elev. of Main at tap

Gate at ●

● Gate at

● Curb Box