

LABOR AND MATERIALS

1	Copper Lead	Connection	1		\$
1	Curb	{ Cock Valve T.S. & V.	1	in.	\$
1	Service Box Old returned	{ Short 3 1/2 x 4 1/2 Long 4 1/2 x 5 1/2 Buff. or Rdway			\$
8	Ft.	1	in.	{ Copper Galv Iron Cast Iron	Pipe at \$
	Nipples		in.	at	\$
	Bushings		to	in. at	\$
	Red'g Inc'g	{ Couplings		to in. at	\$
	Union		in.	at	\$
	Meter		in.	at	\$
	Lead Joints			at	\$
	Leadite Joints			at	\$
	Hrs. Foreman			at	\$
	Hrs. Chauffeur			at	\$
	Hrs. Tapper			at	\$
	Hrs. Labor			at	\$
	Hrs. Labor			at	\$
	Hrs. Compressor			at	\$
	Compensation Ins.				\$
	Trucking				\$
	Builders Use of Water				\$
					\$
					\$
					\$
					\$

St.

Pl:

Ave. No. 22


Crandall

Name of Owner

Labor and Mat'l. Report

Aug. 10

1935

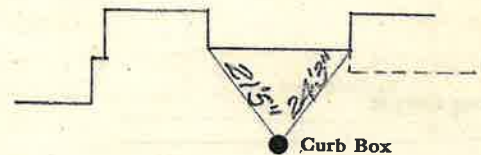

10" Main Montcalm St.

Elev. of
Main at tap. 5'

Gate at ●

● Gate at

● Curb Box

See card for
5 Montcalm

OLD TAP SHUT OFF AT MAIN