


LABOR AND MATERIALS

1	Copper	} Connection	3/4"	\$	
	Lead				
1	Curb	} Cock Valve T.S. & V.	3/4 in.	\$	
1	Service box	} Short 3 1/2 x 4 1/2	}	Same one.	
	Old returned				Long 4 1/2 x 5 1/2
		Buff or Rdway	\$		
6	3/4 in.	} Copper	}	\$	
					G.I.
		G.I.	Pipe at	\$	
	Nipples	in.	at	\$	
	Bushings	to	in.	at	
	Red'g	} Coupl'gs	to	in.	at
	Inc'g				
	Union	in.	at	\$	
	Meter	in.	at	\$	
	Lead Joints	at	\$		
	Compound Joints	at	\$		
	Maintenance Foreman	at	\$		
	Hrs. Water Maint. Man—1	at	\$		
	Hrs. Water Maint. Man—2	at	\$		
	Hrs. Garage Foreman	at	\$		
	Hrs. Labor—	at	\$		
	Hrs. Compressor	at	\$		
	Compensation Ins.	at \$	per C	\$	
	Trucking	\$			
	Pav't Patch	\$			
	Tap by Seymour & Co.	\$			
	8-17-71	\$			
	O'head	\$			
		\$			

St. Crandall Ave. No. 29

Name of Owner A. Metivier

Labor and Mat'l. Report Aug. 17 1971

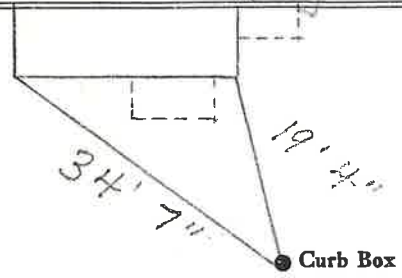

10" Main Elev. of Main at tap 110 1/2

Gate at ● Gate at ●

● Curb Box