

LABOR AND MATERIALS

1	Copper	{ Connection	3/4"		\$ 3.04
	Lead				
1	Curb	{ Cock Valve T.S. & V. }	3/4" in.		\$ 3.54
Same	Service box	{ Short 3 1/2 x 4 1/2			
	Old returned	{ Long 4 1/2 x 5 1/2			
		{ Buff or Rdway			\$ —
16	Ft.	{ Copper			
		{ 3/4" in. }			
		{ Pipe at 35			\$ 5.60
	Nipples	in. at			\$ —
	Bushings	to in. at			\$ —
	Red'g	{ Coupl'gs to in. at			\$ —
	Inc'g				\$ —
	Union	in. at			\$ —
	Meter	in. at			\$ —
	Lead Joints	at			\$ —
	Compound Joints	at			\$ —
8	Hrs. Water Maint. Man—1	at 1.23			\$ 9.84
	Hrs. Water Maint. Man—2	at			\$ —
16	Hrs. Labor	at 1.0 ✓			\$ 16.32
	Hrs. Labor	at			\$ —
2	Hrs. Compressor	at 1.50			\$ 3.00
	Compensation Ins. at \$	per C.			\$ 70
	Trucking				\$ 1.00
	Pav't Patch				\$ 9.00
					\$ —
					\$ —
	O'head				\$ 2.04

Top made by Warsinski
Oct 2 - 1951


15T 1951

Crandall

St. Pl. Ave. No. 30

Name of Owner LaPann

Labor and Mat'l. Report Oct 2, 1951

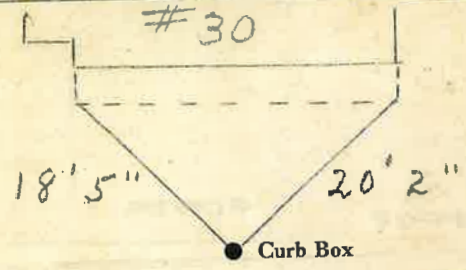

10" Main Elev. of Main at tap 5'

Gate at ● ● Gate at

TAX ID # 309.27-2-4

● Curb Box