


LABOR AND MATERIALS

1	Copper	} Connection $\frac{3}{4}$		\$
	Lead			
1	Curb	} Cock Valve T.S. & V. }	1 in.	\$
1	Service box	} Short $3\frac{1}{2} \times 4\frac{1}{2}$ Long $4\frac{1}{2} \times 5\frac{1}{2}$ }		\$
	Old returned			
16	Ft. 1" in.	} Copper G. I. }	Pipe at	\$
	Nipples	in. at		\$
	Bushings	to in. at		\$
	Red'g Inc'g	} Coupl'gs	to in. at	\$
	Union	in. at		\$
	Meter	in. at		\$
				\$
	Compound Joints	at		\$
	Maintenance Foreman			\$
	Hrs. Water Maint. Man	—1 at		\$
	Hrs. Water Maint. Man	—2 at		\$
	Hrs. Garage Foreman	at		\$
	Hrs. Labor	at		\$
	Hrs. Compressor	at		\$
				\$
	Trucking			\$
	Pav't Patch			\$
				\$
				\$
CRANDALL St. ~~11~~ No. 34

Name of Owner

Labor and Mat'l. Report JULY 26 1924

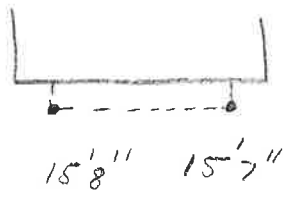

● Curb Box

10" Main Elev. of Main at tap $4\frac{1}{2}$

Gate at ● Gate at

● Curb Box