

LABOR AND MATERIALS

Copper	} Connection		\$	
Lead				
Curb	} Cock Valve T. S. & V. }	in.	\$	
Service box		} Short 3 1/2 x 4 1/2 Long 4 1/2 x 5 1/2 Buff or Rdway }		\$
Old returned				
16 Ft. 1 in.	} Copper G. I. C.I. }		Pipe at	\$
Nipples		in. at	\$	
Bushings		to in. at	\$	
Red'g Inc'g	} Coupl'gs	to in. at	\$	
Union		in. at	\$	
Meter	in. at	\$		
Lead Joints	at	\$		
Compound Joints	at	\$		
Maintenance Foreman		\$		
Hrs. Water Maint. Man-1	at	\$		
Hrs. Water Maint. Man-2	at	\$		
Hrs. Garage Foreman	at	\$		
Hrs. Labor	at	\$		
Hrs. Compressor	at	\$		
Compensation Ins. at \$	per C	\$		
Trucking		\$		
Pav't Patch		\$		
		\$		
		\$		
		\$		
O'head		\$		
		\$		


Crandall

St. PI
Ave. No. 3+55

Name of Owner

Labor and Mat'l. Report

1924

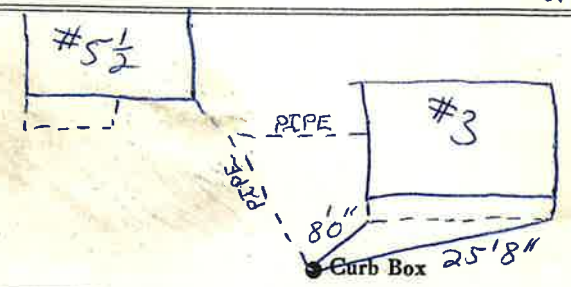

Main Elev. of Main at tap

Gate at • • Gate at

• Curb Box

This curb box shut off for #3 + #5 1/2