


St. Crandall  
 Pl. Ave. No. 39

Name of Owner  
Richard Phelps

Labor and Mat'l. Report Dec 5, 1979

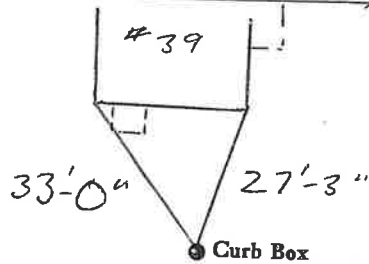

10" Main Elev. of Main at tap 5'  
 Gate at • Gate at •

• Curb Box

LSM-SC-6-1-67

LABOR AND MATERIALS

1 Copper } Connection		\$
Lead } Connection		\$
1 Curb } Cook	} in.	\$
Valve		
T.S. & V.		
1 Service box } Short 3 1/2 x 4 1/2	} \$	
Old returned } Long 4 1/2 x 5 1/2		
Buff or Rdway		
8 Ft. 3/4 in. } Copper	} Pipe at	\$
C.I.		
C.I.		
Nipples	in. at	\$
Bushings	to in. at	\$
Red'g }	} Coupl'gs	to in. at \$
Inc'g }		
Union	in. at	\$
Meter	in. at	\$
Lead Joints	at	\$
Compound Joints	at	\$
Maintenance Foreman		\$
Hrs. Water Maint. Man-1	at	\$
Hrs. Water Maint. Man-2	at	\$
Hrs. Garage Foreman	at	\$
Hrs. Labor	at	\$
Hrs. Compressor	at	\$
Compensation Ins. at \$	per C	\$
Trucking		\$
Pav't Patch		\$
Tip Dec 6, 1979		\$
Trucco + Co.		\$
O'head		\$
		\$