


Labor and Material Report

19

48 *Gravdell St* **Vac Lot**

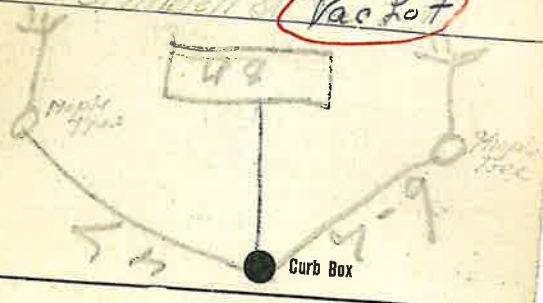

10 Main Elev. of Main at tap 4  
 Gate at ● Gate at ●

*Lot Tap*

Labor and Materials

1	Lead Connection		\$
1	Curb Cock		\$
1	Service Box	(Short 3" x 4")	\$
	Old returned	(Long 4 1/2 x 5 1/2)	\$
		(Buffalo)	\$
20	1 in. G. I. Pipe		\$
	Nipples	in. at	\$
	Bushings	to in. at	\$
	Red'g Coup	to in. at	\$
	Inc'g Coup	to in. at	\$
	Union	in. at	\$
	Meter	in. at	\$
	Cu. Yds. Br. Stone	at	\$
	Cu. Yds. Sand	at	\$
	Bags Cement	at	\$
	Paving Brick	{ Mack Red Asphalt } at	\$
	Hrs. Foreman	at	\$
	Hrs. Common Labor	at	\$
	Hrs. Mason	at	\$
2	Hrs. <i>Paint</i>	at	\$
	Hrs.	at	\$
	Builders' Use of Water	at	\$
		at	\$
		at	\$
Total \$ 15.26