


LABOR AND MATERIALS

1	Copper	Connection	3/4"	\$	_____
1	Lead	Cock		\$	_____
1	Curb	Valve	3/4 in.	\$	_____
		T.S. & V.		\$	_____
Same	Service box	Short 3 1/2 x 4 1/2		\$	_____
	Old returned	Long 4 1/2 x 5 1/2		\$	_____
		Buff or Rdway		\$	_____
23	Ft	3/4 in.	Copper	Pipe at	\$
			G.I.		\$
			G.I.		\$
	Nipples	in.	at	\$	_____
	Bushings	to	in.	at	\$
	Red'g			\$	_____
	Inc'g	Coupl'gs	to	in.	at
	Union	in.	at	\$	_____
	Meter	in.	at	\$	_____
	Lead Joints	at		\$	_____
	Compound Joints	at		\$	_____
	Maintenance Foreman			\$	_____
	Hrs. Water Maint. Man—1	at		\$	_____
	Hrs. Water Maint. Man—2	at		\$	_____
	Hrs. Garage Foreman	at		\$	_____
	Hrs. Labor—	at		\$	_____
	Hrs. Compressor	at		\$	_____
	Compensation Ins.	at \$	per C	\$	_____
	Trucking			\$	_____
	Pav't Patch			\$	_____
	Tap by Giggard			\$	_____
	6-1-60			\$	_____
	O'head			\$	_____
				\$	_____

St. Crandall
Pl. 52
Ave. No. 52

Name of Owner
Mrs. John Mulhealy

Labor and Mat'l. Report June 6 1960

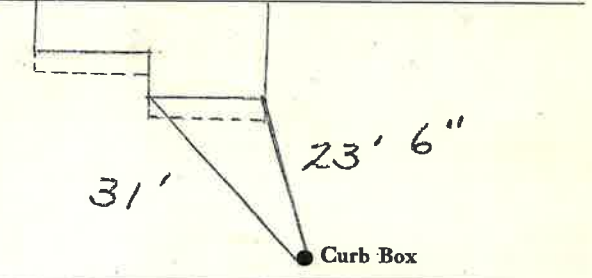

10" Main Elev. of Main at tap 5 1/2'

Gate at • Gate at •

• Curb Box