

LABOR AND MATERIALS


1 Copper	} Connection	1 1/2"	\$
Lead			
1 Curb	} Cock Valve T.S. & V.	1 1/2 in. Oriseal	\$
1 Service box	} Short 3 1/2 x 4 1/2 Long 4 1/2 x 5 1/2 Buff or Rdway	5' Oriseal	\$
Old returned			
			Curb box.
13 1/2 Ft. 1 1/2 in.	} Copper C.I. C.I.	Pipe at	\$
Nipples	in. at		\$
Bushings	to in. at		\$
Red'g } Inc'g }	Coupl'gs	to in. at	\$
Union	in. at		\$
Meter	in. at		\$
Lead Joints	at		\$
Compound Joints	at		\$
Maintenance Foreman			\$
Hrs. Water Maint. Man-1	at		\$
Hrs. Water Maint. Man-2	at		\$
Hrs. Garage Foreman	at		\$
Hrs. Labor	at		\$
Hrs. Compressor	at		\$
Compensation Ins.	at \$ per C		\$
Trucking			\$
Pav't Patch			\$
Tap by Laredo + Co			\$
			\$
			\$
O'head			\$
			\$

Crandall

St. Pt. Ave. No. 6

Name of Owner
Saint Alphonsus Church

Labor and Mat'l. Report Aug 31 1965

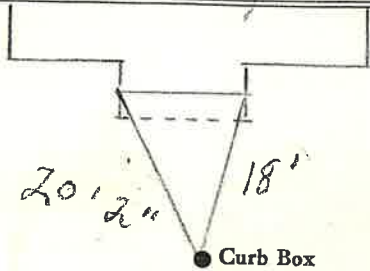

8" Main Elev. of Main at tap 5'

Gate at • • Gate at

• Curb Box