


LABOR AND MATERIALS

1	Copper	} Connection $\frac{3}{4}$	\$	
	Lead			
1	Curb	} Cock } Valve } 1" in.	\$	
			} T. S. & V.	
1	Service box			{ Short $3\frac{1}{2} \times 4\frac{1}{2}$ } Long $4\frac{1}{2} \times 5\frac{1}{2}$
	Old returned			
19 Ft.	1" in.	{ Copper } G. I. } Pipe at	\$	
	Nipples	in. at	\$	
1	Bushings	1" to $\frac{1}{2}$ " in. at	\$	
	Red'g	} Coupl'gs to in. at	\$	
	Inc'g			
	Union	in. at	\$	
	Meter	in. at	\$	
			\$	
	Compound Joints	at	\$	
	Maintenance Foreman		\$	
	Hrs. Water Maint. Man—1	at	\$	
	Hrs. Water Maint. Man—2	at	\$	
	Hrs. Garage Foreman	at	\$	
	Hrs. Labor	at	\$	
	Hrs. Compressor	at	\$	
			\$	
	Trucking		\$	
	Pay't Patch		\$	
			\$	
			\$	
			\$	
			\$	

St. GRANDALL
 Ave. No. 56
 Name of Owner

Labor and Mat'l. Report SEPT 22 1924

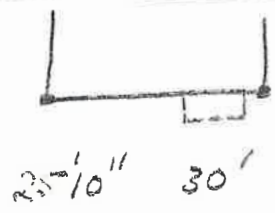

● Curb Box

10" Main Elev. of Main at tap 4 $\frac{1}{2}$ '

Gate at ● Gate at ●

TAX ID # 302.19-28-4

● Curb Box