

LABOR AND MATERIALS

1	Copper	} Connection	3/4"	\$	308
	Lead				
1	Curb	} Cock Valve	3/4" in.	\$	3.89
1	Service box	} Short 3 1/2 x 4 1/2		\$	4.32
	Old returned				
			Buff or Rdway		
10	Ft.	} Copper	3/4 in.	\$	450
			Pipe at		45
	Nipples	in.	at	\$	
	Bushings	to	in.	at	\$
	Red'g	} Coupl'gs.	to	in.	at
	Inc'g				
	Union	in.	at	\$	
	Meter	in.	at	\$	
	Lead Joints	at		\$	
	Compound Joints	at		\$	
	Maintenance Foreman			\$	
	Hrs. Water Maint. Man-1	at		\$	
	Hrs. Water Maint. Man-2	at		\$	1.61
11	Hrs. Garage Foreman	at	2080	\$	2236
31	Hrs. Labor	at	1.30	\$	40.30
2	Hrs. Compressor	at	1.49	\$	2.96
	Compensation Ins.	at \$5.686	per C	\$	3.82
	Trucking			\$	1.50
	Pav't Patch			\$	6.72
	Tap made July 3 '56			\$	
	by Wadleigh Plureau			\$	
	O'head			\$	
				\$	95.06


6723

Crandall

St. Pl. Ave. No. 61

Name of Owner  
B. Alexander

Labor and Mat'l. Report July 3 1956

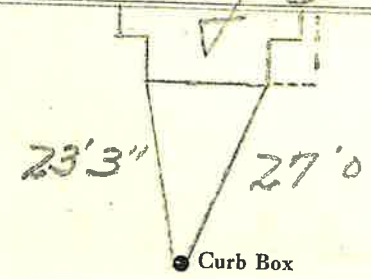

10" Main Elev. of Main at tap 6'

Gate at • Gate at

• Curb Box