


LABOR AND MATERIALS .

1 Copper } Connection $\frac{3}{4}$ " \$
 1 Curb } Cock Valve } $\frac{3}{4}$ in. oriser \$
 1 Service box { Short $3\frac{1}{2}$ x $4\frac{1}{2}$ }
 Old returned { Long $4\frac{1}{2}$ x $5\frac{1}{2}$ }
 13 $\frac{1}{2}$ Ft. $\frac{3}{4}$ in. { Copper } Pipe at \$
 { C.P. }
 { Galv. }
 Nipples in. at \$
 Bushings to in. at \$
 Red'g }
 Inc'g } Coupl'gs to in. at \$
 Union in. at \$
 Meter in. at \$
 Lead Joints at \$
 Compound Joints at \$
 Maintenance Foreman \$
 Hrs. Water Maint. Man-1 at \$
 Hrs. Water Maint. Man-2 at \$
 Hrs. Garage Foreman at \$
 Hrs. Labor at \$
 Hrs. Compressor at \$
 Compensation Ins. at \$ per C \$
 Trucking \$
 Pav't Patch \$
 Tapped by Purvis & Co \$
 O'head MAY-27-1974 \$
 \$

Crandall St. No. 7
 Pt. Ave.

Name of Owner
 J. Orlow & M. Alund

Labor and Mat'l. Report MAY-27 1974

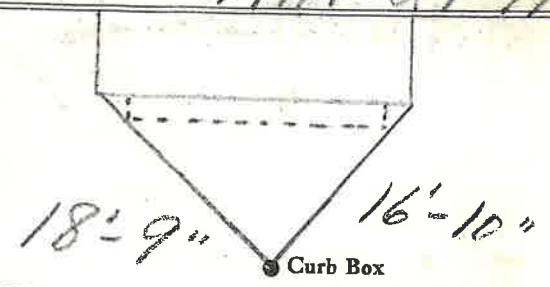

10" Main Elev. of Main at tap 5 $\frac{1}{2}$ '
 Gate at • Gate at •

• Curb Box