


Labor and Materials

1	Lead Connection	3	\$
1	Curb Cock		\$
1	Service Box (Short 34 x 4)		\$
	Old returned (Long 4 1/2 x 5 1/2)		\$
	Buffalo		\$
10	Ft. 1 in. G. I. Pipe at		\$
	Nipples in. at		\$
	Bushings to in. at		\$
	Red'g Coup. to in. at		\$
	Inc'g Coup. to in. at		\$
	Union in. at		\$
	Meter in. at		\$
	Cu. Yds. Br. Stone at		\$
	Cu. Yds. Sand at		\$
	Bags Cement at		\$
	Paving Brick { Mack Red Asphalt } at		\$
2	Hrs. Foreman at		\$
4	Hrs. Common Labor at		\$
	Hrs. Mason at		\$
	Hrs. at		\$
	Hrs. at		\$
20	Builders' Use of Water		\$
	Trucks 100		\$
	at		\$
	at		\$
	at		\$
	at		\$
	Total	\$ 11.40	

August 4
Labor and Material Report

19

67 Randall St

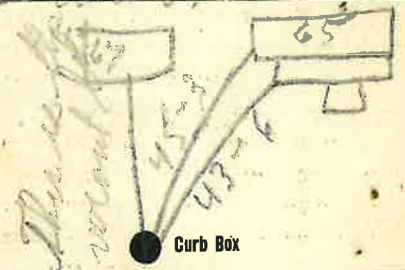

10 Main Elev. of Main at tap 4
Gate at ● Gate at ●

● Curb Box

VACANT LOT Tap