

LABOR AND MATERIALS

3/4" <sup>Copper</sup> Lead	Connection	3/4"	\$
1 Curb	Cock Valve T.S. & V.	3/4" in.	\$
1 Service box Old returned	Short 3 1/2 x 4 1/2 Long 4 1/2 x 5 1/2		\$
13 Ft. 7" in.	Copper G.I. Pipe at		\$
Nipples	in. at		\$
1 Bushings	2 to 3/4" in. at		\$
Red'g Inc'g	Coupl'gs. to in. at		\$
Union	in. at		\$
Meter	in. at		\$
Compound Joints	at		\$
Maintenance Foreman			\$
Hrs. Water Maint. Man-1	at		\$
Hrs. Water Maint. Man-2	at		\$
Hrs. Garage Foreman	at		\$
Hrs. Labor	at		\$
Hrs. Compressor	at		\$
Trucking	Taylor CURT		\$
Pav't Patch	shown		\$
			\$
			\$

CRANDALL

St. ~~Pl.~~ Ave. No. 69

Name of Owner

OCT 11 2006  
~~SEATED~~ 19 1/4

Labor and Mat'l. Report

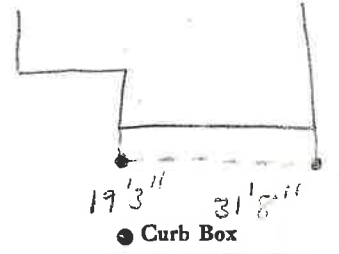

10" Main

Elev. of Main at tap 4'

Gate at •

• Gate at

• Curb Box

new TAP 3/4 old OFF AT CORP.