


LABOR AND MATERIALS

1	Copper Lead	Connection	$\frac{3}{4}$	\$
1	Curb	Cock Valve T.S. & V.	$\frac{3}{4}$ in.	\$
1	Service box	Short $3\frac{1}{2} \times 4\frac{1}{2}$		
	Old returned	Long $4\frac{1}{2} \times 5\frac{1}{2}$		\$
11	Ft.	Copper Pipe	$\frac{3}{4}$ in.	\$
	Nipples	in.	at	\$
	Bushings	to	in. at	\$
1	Redig. Insg.	Coupl'gs	$\frac{3}{4}$ to	in. at \$
	Union	in.	at	\$
	Meter	in.	at	\$
	Compound Joints	at		\$
	Maintenance Foreman			\$
	Hrs. Water Maint. Man-1	at		\$
	Hrs. Water Maint. Man-2	at		\$
	Hrs. Garage Foreman	at		\$
	Hrs. Labor	at		\$
	Hrs. Compressor	at		\$
	Trucking			\$
	Pav't Patch			\$
				\$
				\$
				\$
				\$

St. CRANDALL
 Pl. 73-75
 Ave. No.

Name of Owner

Labor and Mat'l. Report JUNE 17 1927

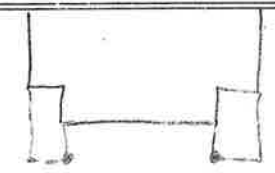

19'10" 10'10"

● Curb Box

10" Main Elev. of Main at tap 4'

Gate at ● Gate at

● Curb Box

OLD TAP SHUT OFF