

LABOR AND MATERIALS


1	Copper Lead	Connection			\$
1	Curb	Cock Valve T.S. & V.	3/4 in.		\$
1	Service box Old returned	Short 3 1/2 x 4 1/2 Long 4 1/2 x 5 1/2			\$
25	Ft.	3/4 in. Copper G.I. C.I.	Pipe at		\$
	Nipples	in. at			\$
	Bushings	to in. at			\$
1	Red'g Ine'g	Coupl'gs. 3/4 to	in. at		\$
	Union	in. at			\$
	Meter	in. at			\$
	Compound Joints	at			\$
	Maintenance Foreman				\$
	Hrs. Water Maint. Man-1	at			\$
	Hrs. Water Maint. Man-2	at			\$
	Hrs. Garage Foreman	at			\$
	Hrs. Labor	at			\$
	Hrs. Compressor	at			\$
	Trucking				\$
	Pav't Patch				\$
					\$
					\$
St. ~~PK~~ Ave. No. 76

CRANDALL

Name of Owner _____

Labor and Mat'l. Report JUNE 17 19 27

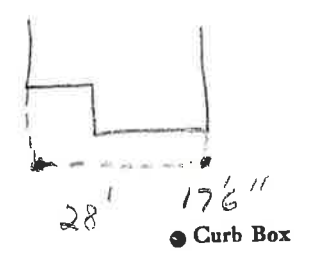

10" Main Elev. of Main at tap 4'

Gate at ● ● Gate at

● Curb Box

OLD TAP SHUT OFF