


LABOR AND MATERIALS

1	Copper	} Connection $\frac{3}{4}$	\$
Lead			
1	Curb	} Cock Valve T.O. & V. } $\frac{3}{4}$ in.	\$
1	Service box	} Short $3\frac{1}{2} \times 4\frac{1}{2}$ Long $4\frac{1}{2} \times 5\frac{1}{2}$ }	\$
	Old returned		
24	Ft. $\frac{3}{4}$ in.	} Copper } Pipe at	\$
	Nipples	in. at	\$
1	Bushings	$\frac{3}{4}$ to in. at	\$
1	Redg. Inc'g	} Coupl'gs $\frac{3}{4}$ to in. at	\$
	Union	in. at	\$
	Meter	in. at	\$
			\$
	Compound Joints	at	\$
	Maintenance Foreman		\$
	Hrs. Water Maint. Man—1	at	\$
	Hrs. Water Maint. Man—2	at	\$
	Hrs. Garage Foreman	at	\$
	Hrs. Labor—	at	\$
	Hrs. Compressor	at	\$
			\$
	Trucking		\$
	Pav't Patch		\$
			\$
			\$
			\$
			\$

St. ~~PH~~ Ave. No. 84
CRANDALL
 Name of Owner TAX ID # 302.19-16-3

Labor and Mat'l. Report JUNE 20 19 27

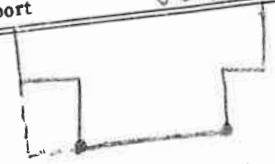

26' 11" 24' 8"

● Curb Box

10" Main

Elev. of Main at tap 4'

Gate at ●

● Gate at

● Curb Box

OLD TAP SHUT OFF