


LABOR AND MATERIALS

1	Copper Lead	Connection	$\frac{3}{4}$	\$
1	Curb	Cock Valve T.S. & V.	in.	\$
1	Service box Old returned	Short $3\frac{1}{2} \times 4\frac{1}{2}$ Long $4\frac{1}{2} \times 5\frac{1}{2}$		\$
21	Ft.	$\frac{3}{4}$ in. Copper C.I. C.I.	Pipe at	\$
	Nipples	in. at		\$
	Bushings	to in. at		\$
	Red'g Inc'g	Coupl'gs to in. at		\$
	Union	in. at		\$
	Meter	in. at		\$
	Compound Joints	at		\$
	Maintenance Foreman			\$
	Hrs. Water Maint. Man-1	at		\$
	Hrs. Water Maint. Man-2	at		\$
	Hrs. Garage Foreman	at		\$
	Hrs. Labor	at		\$
	Hrs. Compressor	at		\$
	Trucking			\$
	Pav't Patch			\$
				\$
				\$
				\$
				\$

St. CRAWDALL
 Ave. No. 90

Name of Owner _____

Labor and Mat'l. Report MAY 1927

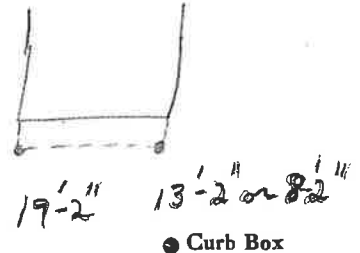

Main Elev. of Main at tap 4'
 Gate at ● Gate at ●

● Curb Box

Labor and Materials

.....	Copper } Connection $3/4$	\$ 1.25
.....	Lead }	
.....	Curb { Cock Valve T.S.&V. } $3/4$ in	\$ 1.70
.....	Service Box { Short $3\frac{1}{2} \times 4\frac{1}{2}$ Long $4\frac{1}{2} \times 5\frac{1}{2}$ Old returned Buff. or Rdwry. }	\$ 1.37
.....	13 Ft. $3/4$ in. { Copper Galv. Iron Cast Iron } Pipe at $13\frac{1}{2}$	\$ 1.76
.....	Nipples in. at	\$
.....	Bushings to in. at	\$
.....	Red'g Inc'g } Couplings..... to in. at	\$
.....	Union..... in. at	\$
.....	Meter..... in. at	\$
.....	Lbs. Br. Stone at	\$
.....	Lbs. Sand at	\$
.....	Bags Cement at	\$
.....	Paving Brick { Mack Red Asphalt } at	\$
.....	Lead Joints at	\$
.....	Leadite Joints at	\$
3	Hrs. Foreman at $6.27/2$	\$ 1.88
2	Hrs. Common Labor at 50	\$ 1.00
6	Hrs. Common Labor at 45	\$ 2.70
.....	Hrs. Mason at	\$
.....	Hrs. Masons Helper at	\$
.....	Hrs. Compressor at	\$
.....	Compensation Ins	\$ 2.00
.....	Trucking	\$ 1.00
.....	Builders Use of Water	\$
Total \$ 12.87		

1935-187

Labor and Material Report Oct 21 1936

3/4 inch #45 Wrought lat wire



30'-4" 26'-4"

Curb Box

GRANT AVE

4" Main

Elev of Main at tap

Gate at #90 Crandall Gate at

CRANDALL ST.

Curb Box

New tap
MMS

Not in use
see little slip

Labor and Materials

1 Lead Connection	\$
1 Curb Cock	\$
1 Service Box { Short 3 1/2 x 4 1/2	\$
1 Old returned { Long 4 1/2 x 6 1/2	\$
18 Ft. 1 in. G. I. Pipe at	\$
Nipples in. at	\$
Bushings 1/2 to 3/4 in. at	\$
Red'g Coup to in. at	\$
Inc'g Coup to in. at	\$
Union in. at	\$
Meter in. at	\$
Cu. Yds. Br. Stone at	\$
Cu. Yds. Sand at	\$
Bags Cement at	\$
Paving Brick { Mack { Red { Asphalt } at	\$
5 Hrs. Foreman at	\$
1.7 Hrs. Common Labor at	\$
Hrs. Mason at	\$
Hrs. at	\$
Hrs. at	\$
9.5 Builders' Use of Water	\$
..... at	\$
..... at	\$
Total	\$ 18.37

3/4 tap at 4 Brandell at



Elev. of Main at tap 4.4

Gate at ● ● Gate at

● Curb Box