

LABOR AND MATERIALS


1	Copper	} Connection	$\frac{3}{4}$	\$	
	Lead				
1	Curb	} Cock Valve T.S. & V. }	$\frac{3}{4}$ in.	\$	
1	Service box		} Short $3\frac{1}{2}$ x $4\frac{1}{2}$ } Long $4\frac{1}{2}$ x $5\frac{1}{2}$ }		
	Old returned				\$
24	Ft. $\frac{3}{4}$ in.	} Copper } G.I. } G.I. }	Pipe at	\$	
	Nipples	in. at		\$	
	Bushings	to in. at		\$	
1	Red'g } In'g }	} Coupl'gs $\frac{3}{4}$ to in. at		\$	
	Union	in. at		\$	
	Meter	in. at		\$	
				\$	
	Compound Joints	at		\$	
	Maintenance Foreman			\$	
	Hrs. Water Maint. Man-1	at		\$	
	Hrs. Water Maint. Man-2	at		\$	
	Hrs. Garage Foreman	at		\$	
	Hrs. Labor	at		\$	
	Hrs. Compressor	at		\$	
				\$	
	Trucking			\$	
	Pav't Patch			\$	
				\$	
				\$	
				\$	
				\$	

CRANDALL

St. Pt. Ave. No. 96

Name of Owner
TAX ID # 302.19-10-1

Labor and Mat'l. Report JUNE 21 1927

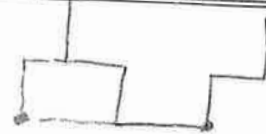

43 1/4" 38 1/2"

● Curb Box

10" Main

Elev. of Main at tap 4'

Gate at ●

● Gate at

● Curb Box

OLD TAP SHUT OFF