


LABOR AND MATERIALS

1	Copper	Connection	3/4"	\$3.20
1	Lead			
1	Curb	Cock Valve	3/4 in.	\$1.00
		T.S. & V.		
1	Service box	Short 3 1/2 x 4 1/2		
	Old returned	Long 4 1/2 x 5 1/2		
		Buff or Rdway		\$1.30
12	Ft.	Copper	Pipe at	\$26.4
		C.I.		
		C.I.		
	Nipples	in. at		\$
	Bushings	to in. at		\$
	Red'g			
	Inc'g	Coupl'gs to in. at		\$
	Union	in. at		\$
	Meter	in. at		\$
	Lead Joints at			\$
	Compound Joints at			\$
	Maintenance Foreman			\$
	Hrs. Water Maint. Man-1 at			\$
	Hrs. Water Maint. Man-2 at			\$
2	Hrs. Garage Foreman	at 50		\$100
7	Hrs. Labor	at		\$28.4
	Hrs. Compressor at			\$
	Compensation Ins. at \$	per C		\$.10
1	Trucking			\$1.00
	Pav't Patch			\$
				\$
				\$
				\$
	O'head			\$
				\$13.08

Crandall St. Pl. Ave. N 121-3

Name of Owner

Labor and Mat'l. Report June 23 1927

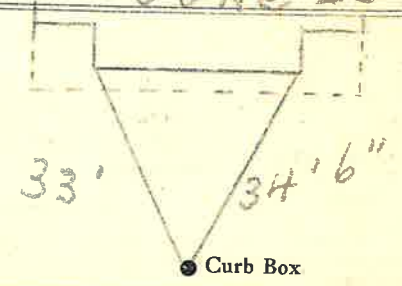

● Curb Box

10" Main

Elev. of Main at tap 5'

Gate at ●

● Gate at

● Curb Box

Old Tap shut off.