


LABOR AND MATERIALS

1	Copper Lead	} Connection $\frac{3}{4}$	\$
1	Curb		} Cock Valve T.S. & V. } $\frac{3}{4}$ in.
1	Service box Old returned	} Short $3\frac{1}{2} \times 4\frac{1}{2}$ Long $4\frac{1}{2} \times 5\frac{1}{2}$ }	
28	Ft. $\frac{3}{4}$ in.		} Copper C.I. C.I.
	Nipples	in. at \$	
1	Bushings	$\frac{3}{4}$ to $\frac{1}{2}$ in. at \$	
1	Red'g In'g	} Coupl'gs $\frac{3}{4}$ to	in. at \$
	Union		
	Meter	in. at \$	
	Compound Joints	at \$	
	Maintenance Foreman	\$	
	Hrs. Water Maint. Man-1	at \$	
	Hrs. Water Maint. Man-2	at \$	
	Hrs. Garage Foreman	at \$	
	Hrs. Labor	at \$	
	Hrs. Compressor	at \$	
	Trucking	\$	
	Pav't Patch	\$	
		\$	
		\$	
St. CRANDILL No. 124-26

Name of Owner

Labor and Mat'l. Report JUNE 23 1927

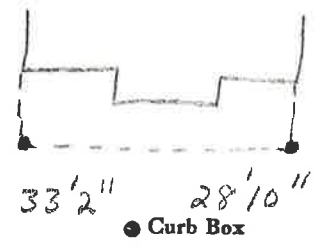

10' Main

Elev. of Main at tap 5'

Gate at • Gate at

• Curb Box

OLD TAP SHUT OFF