

### LABOR AND MATERIALS

|   |                                 |                    |               |          |
|---|---------------------------------|--------------------|---------------|----------|
| 1 | Copper } Connection             | 3/4                |               | \$ 1.35  |
|   | Lead }                          |                    |               |          |
| 1 | Curb } Cock Valve               | 3/4                | in.           | \$ 1.88  |
|   |                                 |                    |               |          |
| 1 | Service Box } Short 3/4x4 1/2   |                    |               |          |
|   | Old returned } Long 4 1/2x5 1/2 |                    |               | \$ 1.82  |
|   |                                 |                    | Buff or Rdway |          |
| 7 | Ft. } in.                       | 3/4                | in.           |          |
|   |                                 |                    |               |          |
|   |                                 |                    | Pipe at 20.   | \$ 1.40  |
|   |                                 |                    |               |          |
|   | Nipples.....                    |                    | in. at        | \$       |
|   | Bushings.....                   |                    | to.....in. at | \$       |
|   | Red'g } Couplings.....          |                    | to.....in. at | \$       |
|   | Inc'g }                         |                    |               |          |
|   | Union.....                      |                    | in. at        | \$       |
|   | Meter.....                      |                    | in. at        | \$       |
|   | Lead Joints at                  |                    |               | \$       |
|   | Leadite Joints at               |                    |               | \$       |
|   | Hrs. Foreman at                 |                    |               | \$       |
| 3 | Hrs. Chauffeur at               | 6 1/2              |               | \$ 1.88  |
| 3 | Hrs. Tapper at                  | 7                  |               | \$ 1.87  |
| 4 | Hrs. Labor at                   | 45                 |               | \$ 1.80  |
|   | Hrs. Labor at                   |                    |               | \$       |
|   | Hrs. Compressor at              |                    |               | \$       |
|   | Compensation Ins.               |                    |               | \$ .17   |
|   | Trucking                        |                    |               | \$ 1.-   |
|   | Builders Use of Water           | hospital - 200 ft. |               | \$       |
|   | Taply Paper                     |                    |               | \$       |
|   |                                 |                    |               | \$       |
|   |                                 |                    |               | \$       |
|   |                                 |                    |               | \$ 13.17 |

3 1942

11

St.

Pl.

Ave. No. 7

Culvert


Name of Owner

Mrs. H. H. Robertson

Labor and Mat'l. Report

Apr 25

1941

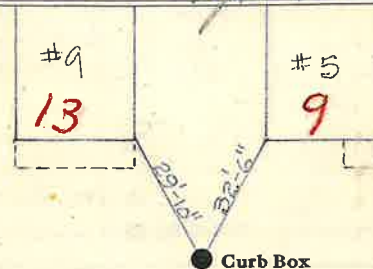

4 Gal Main

Elev. of

Main at tap 4 1/2

Gate at ●

● Gate at

● Curb Box