

LABOR AND MATERIALS

1	Copper Lead	} Connection	$\frac{3}{4}$	in.	\$
1	Curb Valve P.S. & V.				
1	Service box Old returned	} Short $3\frac{1}{2} \times 4\frac{1}{2}$ Long $4\frac{1}{2} \times 5\frac{1}{2}$			\$
8	Ft. $\frac{3}{4}$ in.				
	Nipples	in. at	\$		
	Bushings	to in. at	\$		
	Red'g Inc'g	} Coupl'gs	to in. at	\$	
	Union				in. at
	Meter	in. at	\$		
	Compound Joints	at	\$		
	Maintenance Foreman		\$		
	Hrs. Water Maint. Man—1	at	\$		
	Hrs. Water Maint. Man—2	at	\$		
	Hrs. Garage Foreman	at	\$		
	Hrs. Labor	at	\$		
	Hrs. Compressor	at	\$		
	Trucking		\$		
	Pav't Patch		\$		
			\$		
			\$		

CULVERT

St. Pl. Ave. No. 13

Name of Owner

Labor and Mat'l. Report

SEPT 28 19 36

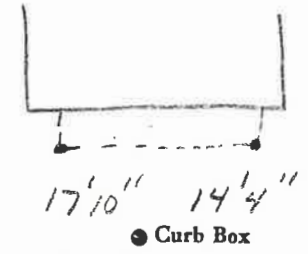

4" Main

Elev. of Main at tap 5'

Gate at ●

● Gate at

● Curb Box

OLD SHUT OFF AT MAIN

TAX ID # 303.17-19-14