

LABOR AND MATERIALS

1	Copper Lead	Connection	-----	\$	1.23
1	Curb	{ Cock Valve T.S. & V. }	3/4 in.	\$	1.68
1	Service Box Old returned	{ Short 3 1/2 x 4 1/2 Long 4 1/2 x 5 1/2 Buff. or Rdway }		\$	1.75
10	Ft.	3/4 in. { Copper Galv Iron Cast Iron }	Pipe at	15	\$ 1.50
	Nipples	in. at	-----	\$	
	Bushings	to in. at	-----	\$	
	Red'g Inc'g	{ Couplings	to in. at	\$	
	Union	in. at	-----	\$	
	Meter	in. at	-----	\$	
	Lead Joints	at	-----	\$	
	Leadite Joints	at	-----	\$	
	Hrs. Foreman	at	-----	\$	
2	Hrs. Chauffeur	at	6 2 1/2	\$	1.25
6	Hrs. Tapper	at		\$	3.75
6	Hrs. Labor	at	45	\$	2.70
	Hrs. Labor	at	-----	\$	
2	Hrs. Compressor	at	87 1/2	\$	1.75
	Compensation Ins.		-----	\$	24
	Trucking		-----	\$	1-
	Builders Use of Water	1/2 Batch (Swim)	-----	\$	2.50
	Top by Hassel		-----	\$	
			-----	\$	
			-----	\$	
			-----	\$	
			-----	\$	19.35

163-38

St. 18

Cunningham

Pl. -----

Ave. No. 10


Name of Owner

Hasselton E. L. Welcyng

Labor and Mat'l. Report

Dec. 1,

1938

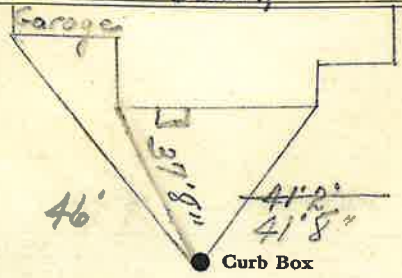

6" Main

Elev. of Main at tap 5'

Gate at ●

● Gate at

● Curb Box

New House