


LABOR AND MATERIALS

1	Copper } Connection	$\frac{3}{4}$	\$
	Lead }		
1	Curb } Cock	$\frac{3}{4}$ in.	\$
	Valve }		
	T.S. & V. }		
1	Service box } Short $2\frac{1}{2} \times 4\frac{1}{2}$	}	\$
	Old returned } Long $4\frac{1}{2} \times 5\frac{1}{2}$		
24	Ft. $\frac{3}{4}$ in. } Copper	} Pipe at	\$
	Nipples	in. at	\$
	Bushings	to in. at	\$
	Red'g } Inc'g	} Coupl'gs. to in. at	\$
	Union	in. at	\$
	Meter	in. at	\$
			\$
	Compound Joints	at	\$
	Maintenance Foreman		\$
	Hrs. Water Maint. Man-1	at	\$
	Hrs. Water Maint. Man-2	at	\$
	Hrs. Garage Foreman	at	\$
	Hrs. Labor-	at	\$
	Hrs. Compressor	at	\$
			\$
	Trucking		\$
	Pav't Patch		\$
			\$
			\$
CUNNINGHAM ~~St.~~ Ave. No. 19

Name of Owner

Labor and Mat'l. Report MAY 29 1930

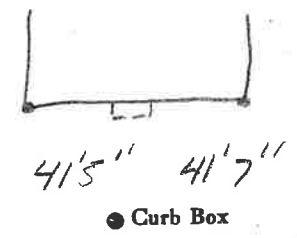

6" Main Elev. of Main at tap 4'

Gate at • Gate at •

● Curb Box