

Labor and Materials

1	Copper Lead	Connection	3/4	\$ 1.23
1	Curb	Cock Valve Tr. & V.	3/4	\$ 1.68
1	Service Box	Short 3 1/2 x 4 1/2		\$ 1.75
	Old returned	Long 4 1/2 x 5 1/2		
		Diff. or Rdway		
15	Ft. 3/4 in.	Copper Galv Iron	Pipe at 15	\$ 2.25
	Nipples	in. at		\$
	Bushings	to in. at		\$
	Red'g Inc'g	Conplings to in. at		\$
	Union	in. at		\$
	Meter	in. at		\$
	Lead Joints	at		\$
	Leadite Joints	at		\$
	Hrs. Foreman	at		\$
1	Hrs. Chauffeur	at 6 1/2		\$ 63
4	Hrs. Tapper	at 7		\$ 50
4	Hrs. Labor	at 7 1/2		\$ 1.80
	Hrs. Labor	at		\$
	Hrs. Compressor	at		\$
	Compensation Ins.			\$ 23
	Trucking			\$ 1.00
	Builders Use of Water	100 gal (Seven)		\$ 2.50
	Top by HESSON			\$
	Water main			\$
				\$
				\$
				\$
				\$
				\$ 17.05

136-3A

Cunningham


St. Pl. Ave. No. 20

Name of Owner

Brank Coal & Lumber

Labor and Mat'l. Report

Oct. 5, 1938

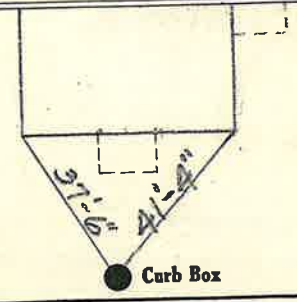

6" Main

Elev. of Main at tap 5'

Gate at ●

● Gate at

● Curb Box

New House