

LABOR AND MATERIALS

1	Copper	{ Connection	3/4	\$	2.87
	Lead				
1	Curb	{ Cock Valve T.S. & V.	3/4 in.	\$	3.62
1	Service box	{ Short 3 1/2 x 1 1/2		\$	4.68
	Old returned	{ Long 4 1/2 x 5 1/2		\$	
		{ Buff. or Redway		\$	
14	Ft. 3/4 in.	{ Copper	Pipe at 32	\$	4.48
		{ C.I.			
	Nipples	in. at		\$	
	Bushings	to in. at		\$	
	Red'g Inc'g	{ Coupl'gs to in. at		\$	
	Union	in. at		\$	
	Meter	in. at		\$	
	Lead Joints	at		\$	
	Compound Joints	at		\$	
	Hrs. Water Maint. Man-1	at		\$	
2	Hrs. Water Maint. Man-2	at 1.02		\$	2.04
	Hrs. Labor	at		\$	
	Hrs. Labor	at		\$	
	Hrs. Compressor	at		\$	
	Compensation Ins. at \$ 2.18	per C.		\$.04
	Trucking			\$	2.00
	Pav't Patch			\$	10.25
	<i>Apply to Engineer</i>			\$	
				\$	
				\$	
	O'head			\$	
				\$	29.98

125

St. 26
Pl. 17
Ave. No. 17


Cunningham

Name of Owner

Witham

Labor and Mat'l. Report

Nov 14 1949

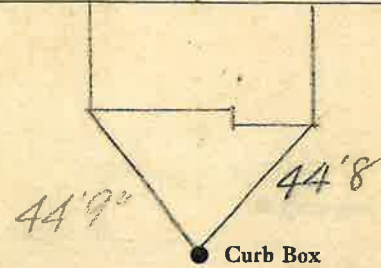

6 1/2" Main

Elev. of Main at tap 5'

Gate at ●

● Gate at

● Curb Box