

LABOR AND MATERIALS

1	Copper Lead	Connection	3/4"	\$
1	Curb	Cock Valve T.S. & V.	3/4 in.	\$
1	Service box Old returned	Short 3 1/2 x 4 1/2 Long 4 1/2 x 5 1/2 Buff or Rdway		\$
27	Ft.	3/4 in. Copper C.I. Pipe at		\$
	Nipples	in. at		\$
	Bushings	to in. at		\$
	Red'g Inc'g	Coupl'gs to in. at		\$
	Union	in. at		\$
	Meter	in. at		\$
	Lead Joints	at		\$
	Compound Joints	at		\$
	Maintenance Foreman			\$
	Hrs. Water Maint. Man	1 at		\$
	Hrs. Water Maint. Man	2 at		\$
	Hrs. Garage Foreman	at		\$
	Hrs. Labor	at		\$
	Hrs. Compressor	at		\$
	Compensation Ins.	at \$ per C		\$
	Trucking			\$
	Pay't Patch			\$
	Top made Aug 9-57 by Gifford & Co			\$
	O'head			\$


Str. Pl. No. 27 ✓

Cunningham

Name of Owner

Lazarus

Labor and Mat'l. Report Aug 9 1957

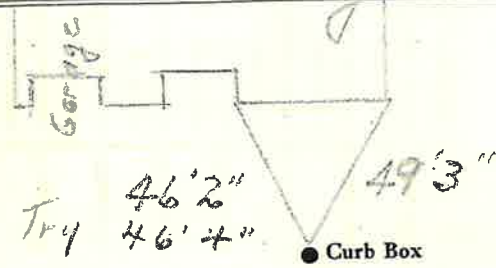

6" Main Elev. of Main at tap 5'

Gate at • Gate at

27' to MAIN

3/4" Copper • Curb Box