

LABOR AND MATERIALS

1	Copper Lead	{ Connection	3/4"		\$ 3.04
1	Curb	{ Cock Valve T. S. & V.	3/4 in.		\$ 3.54
1	Service box Old returned	{ Short 3 1/2 x 4 1/2 Long 4 1/2 x 5 1/2 Buff or Rdway			\$ 4.70
10	Ft. 3/4 in.	{ Copper C. I. C. I.	Pipe at	35	\$ 3.50
	Nipples	in. at			\$
	Bushings	to in. at			\$
	Red'g Inc'g	{ Coupl'gs	to in. at		\$
	Union	in. at			\$
	Meter	in. at			\$
	Lead Joints at				\$
	Compound Joints at				\$
	Hrs. Water Maint. Man-1 at				\$
	Hrs. Water Maint. Man-2 at				\$
4	Hrs. Labor	at	1.02		\$ 4.08
	Hrs. Labor	at			\$
	Hrs. Compressor at				\$
	Compensation Ins. at	\$2.66 per C.			\$ 11
	Trucking				\$ 1
	Pav't Patch				\$
	O'head				\$
	Tapby Gifford				\$ 19.97
	5-16-51				

74-1151

30


Cunningham

St
Fl
Ave. No. 76

Name of Owner

Lots 38-39+40

Labor and Mat'l. Report 5-16-1951

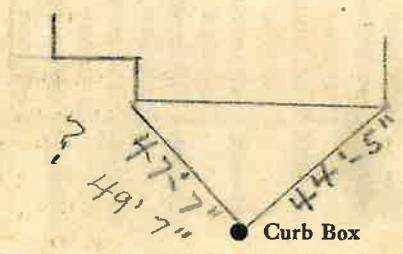

6" Main Elev. of Main at tap 5"

Gate at ● ● Gate at

● Curb Box