

LABOR AND MATERIALS

1	Copper	Connection	3/4"	\$	2.41
1	Lead	Cock	3/4 in.	\$	3.41
1	Curb	Valve		\$	
		T.S. & V.		\$	
1	Service box	Short 3 1/2 x 4 1/2		\$	4.18
	Old returned	Long 4 1/2 x 5 1/2		\$	
		Buff or Rdway		\$	
9	Ft.	Copper	40	\$	360
		G.I.		\$	
		G.I.		\$	
	Nipples	in. at		\$	
	Bushings	to in. at		\$	
	Red'g			\$	
	Inc'g	Coupl'gs to in. at		\$	
	Union	in. at		\$	
	Meter	in. at		\$	
	Lead Joints	at		\$	
	Compound Joints	at		\$	
	Maintenance Foreman			\$	
	Hrs. Water Maint. Man-1	at		\$	
10	Hrs. Water Maint. Man-2	at 124		\$	13.40
	Hrs. Garage Foreman	at		\$	
8	Hrs. Labor	at 11.3		\$	90.4
	Hrs. Compressor	at		\$	
	Compensation Ins. at	\$ 3.861 per C		\$	83
	Trucking			\$	1.50
	Pay't Patch			\$	14.40
	Top made	Apr 12-54		\$	
	by	Gifford		\$	
	O'head			\$	
				\$	51.77


37.37

15-54

Cunningham Ave. No. 36

Name of Owner  
Linehan

Labor and Mat'l. Report April 12 1954

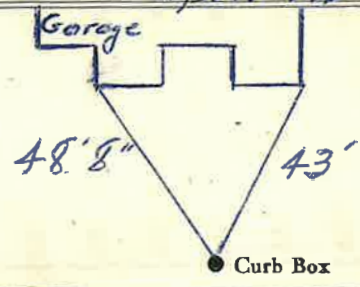

6" Main Elev. of Main at tap 5'

Gate at • Gate at

TAX ID # 302.19-3-3

• Curb Box