

LABOR AND MATERIALS


1	Copper	Connection	3/4"	\$ 2.71
1	Lead	Cock	3/4 in.	\$ 3.83
1	Curb	Valve		
		T.S. & V.		
1	Service box	Short 3 1/2 x 4 1/2		\$ 4.69
	Old returned	Long 4 1/2 x 5 1/2		
		Buff or Rdway		
9	Ft.	Copper	3/4 in. Pipe at 45	\$ 4.05
		G.I.		
		C.I.		
	Nipples	in. at		\$
	Bushings	to in. at		\$
	Red'g	Coupl'gs to in. at		\$
	Inc'g			\$
	Union	in. at		\$
	Meter	in. at		\$
	Lead Joints at			\$
	Compound Joints at			\$
	Maintenance Foreman			\$ 9.00
	Hrs. Water Maint. Man-1 at			\$
6	Hrs. Water Maint. Man-2 at	1.24		\$ 7.44
	Hrs. Garage Foreman	at		\$
12	Hrs. Labor	at 1.13		\$ 13.56
	Hrs. Compressor at			\$
	Compensation Ins. at	\$ 4.29 per C		\$ 9.0
	Trucking			\$ 1.50
	Pav't Patch			\$ 5.40
	Tap by Giffard	6-2-55		\$
	O'head			\$
				\$ 44.08

38.68

Cunningham ~~St.~~ Ave. No. 38  
~~Pl.~~

Name of Owner Allen Center

Labor and Mat'l. Report June 2 1955

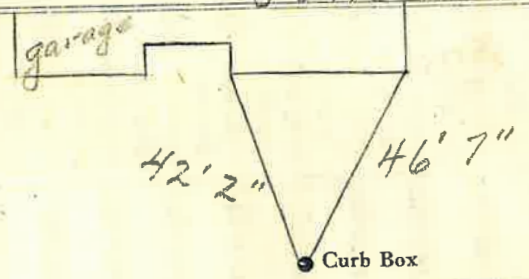

6" Main Elev. of Main at tap 5 1/2'

Gate at • Gate at •

• Curb Box

TAX ID # 302.19-3-4

58