

LABOR AND MATERIALS


1	Copper	} Connection	<u>3/4"</u>		\$
	Lead				
1	Curb	Cock Valve	} <u>3/4 in.</u>		\$
		T.S. & V.			
1	Service box	Short 3 1/2 x 4 1/2			
	Old returned	Long 4 1/2 x 5 1/2			
		Buff or Rdway			\$
12	Ft.	3/4 in.	Copper	Pipe at	\$
			G. I.		
			C. I.		
	Nipples	in. at			\$
	Bushings	to in. at			\$
	Red'g				
	Inc'g	Coupl'gs to in. at			\$
	Union	in. at			\$
	Meter	in. at			\$
	Lead Joints	at			\$
	Compound Joints	at			\$
	Maintenance Foreman				\$
	Hrs. Water Maint. Man-1	at			\$
	Hrs. Water Maint. Man-2	at			\$
	Hrs. Garage Foreman	at			\$
	Hrs. Labor	at			\$
	Hrs. Compressor	at			\$
	Compensation Ins. at \$	per C.			\$
	Trucking				\$
	Pav't Patch				\$
	Tap by Gifford & Co.				\$
					\$
					\$
	O'head				\$
					\$

St. _____
Pl. _____
Ave. No. 40

Name of Owner

Robert VanDuke

Labor and Mat'l. Report Mar. 31 1966

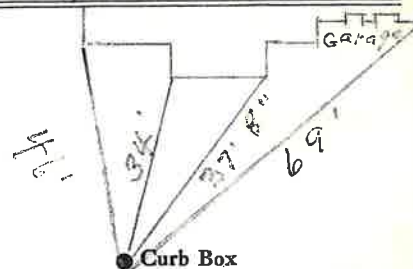

6" Main

Elev. of Main at tap 5 1/2'

Gate at ●

● Gate at

● Curb Box