

LABOR AND MATERIALS

1	Copper Lead	Connection	3/4"	\$	2.41
1	Curb	Cock Valve T. S. & V.	3/4 in.	\$	3.41
1	Service box Old returned	Short 3 1/2 x 4 1/2 Long 4 1/2 x 5 1/2 Buff or Rdway		\$	4.18
26	Ft. 3/4 in.	Copper G.I. C.I.	Pipe at 40	\$	10.40
	Nipples	in. at		\$	
	Bushings	to in. at		\$	
	Red'g Inc'g	Coupl'gs to in. at		\$	
	Union	in. at		\$	
	Meter	in. at		\$	
	Lead Joints at			\$	
	Compound Joints at			\$	
	Maintenance Foreman			\$	
	Hrs. Water Maint. Man-1 at			\$	
6	Hrs. Water Maint. Man-2 at	1.24		\$	7.44
	Hrs. Garage Foreman at			\$	
8	Hrs. Labor at	1.13		\$	9.04
	Hrs. Compressor at			\$	
	Compensation Ins. at	3.861 per C		\$.64
	Trucking			\$	1.50
	Pav't Patch			\$	13.90
	Tap by J. L. G. 6-23-54			\$	
	O'head			\$	
				\$	57.92


39.02

41-54

St. -
Pl. -
Cunningham Ave. No. 51

Name of Owner Hill

Labor and Mat'l. Report June 23 1954

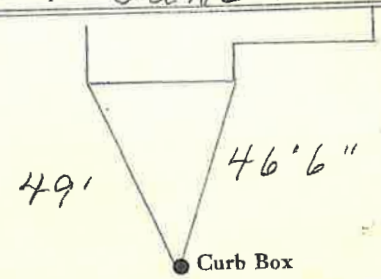

6" Main Elev. of Main at tap 5'

Gate at • • Gate at

TAX ID # 302.19-2-20

• Curb Box