


LABOR AND MATERIALS

1 Copper } Connection 3/4" \$  
~~Lead~~  
 1 Curb } Cock 3/4 in. (MARK "ORISEAL") \$  
~~Lead~~  
 1 Service box } Short 3 1/2 x 4 1/2 } \$  
 Old returned } ~~Long 4 1/2 x 5 1/2~~  
~~Lead~~  
 10 Ft. 3/4 in. } Copper } Pipe at \$  
~~Lead~~ } ~~Galv.~~ }  
 Nipples in. at \$  
 Bushings to in. at \$  
 Red'g }  
 Inc'g } Coupl'gs to in. at \$  
 Union in. at \$  
 Meter in. at \$  
 Lead Joints at \$  
 Compound Joints at \$  
 Maintenance Foreman \$  
 Hrs. Water Maint. Man-1 at \$  
 Hrs. Water Maint. Man-2 at \$  
 Hrs. Garage Foreman at \$  
 Hrs. Labor at \$  
 Hrs. Compressor at \$  
 Compensation Ins. at \$ per C \$  
 Trucking \$  
 Pav't Patch \$  
TAP MADE BY GIFFORD & CO \$  
MAR-28-1973 \$  
 O'head \$  
 \$

CUNNINGHAM Ave. No. 8

Name of Owner PHILIP DUNCAN

Labor and Mat'l. Report MAR 28 1973

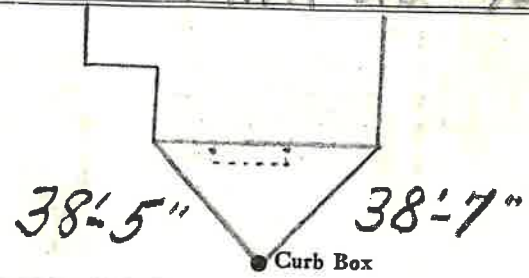

Gate at ● ● Gate at

● Curb Box  
 \* REVERSE CURB STOP