

LABOR AND MATERIALS

1	Copper	} Connection $\frac{3}{4}$	\$
1	Lead		\$
1	Curb	} Cook Valve T.S. & V. } 1" in.	\$
1	Service box		} Short $3\frac{1}{2} \times 4\frac{1}{2}$ Long $4\frac{1}{2} \times 5\frac{1}{2}$
	Old returned		
22	Ft. 1" in.	} Copper G.I. C.P. } Pipe at	\$
	Nipples	in. at	\$
	Bushings	to in. at	\$
	Red'g	} Coupl'gs. to in. at	\$
	Inc'g		
	Union	in. at	\$
	Meter	in. at	\$
			\$
	Compound Joints	at	\$
	Maintenance Foreman		\$
	Hrs. Water Maint. Man-1	at	\$
	Hrs. Water Maint. Man-2	at	\$
	Hrs. Garage Foreman	at	\$
	Hrs. Labor	at	\$
	Hrs. Compressor	at	\$
			\$
	Trucking		\$
	Pav't Patch		\$
			\$
			\$
			\$
			\$


CUNNINGHAM ~~St.~~ Ave. No. 9

Name of Owner

WILLIAMS

Labor and Mat'l. Report

APR 5 1924

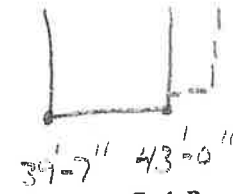

● Curb Box

6" Main Elev. of Main at tap 4 1/2'

Gate at ● Gate at

● Curb Box