

LABOR AND MATERIALS

1	Copper Lead	} Connection	$\frac{3}{4}$	\$
1	Curb		} $\frac{3}{4}$ in.	\$
1	Service box Old returned	} { Short $3\frac{1}{2} \times 4\frac{1}{2}$ Long $4\frac{1}{2} \times 5\frac{1}{2}$		\$
9	Ft. $\frac{3}{4}$ in.		} { Copper C.I. C.I.	Pipe at
	Nipples	in. at		\$
	Bushings	to in. at	\$	
	Red'g Inc'g	} Coupl'gs	to in. at	\$
	Union		in. at	\$
	Meter	in. at	\$	
	Compound Joints	at	\$	
	Maintenance Foreman		\$	
	Hrs. Water Maint. Man	—1 at	\$	
	Hrs. Water Maint. Man	—2 at	\$	
	Hrs. Garage Foreman	at	\$	
	Hrs. Labor	at	\$	
	Hrs. Compressor	at	\$	
	Trucking		\$	
	Pav't Patch		\$	
			\$	
			\$	
			\$	
			\$	


CUNNINGHAM

St. ~~11~~
Ave. No. 14

Name of Owner

Labor and Mat'l. Report

MAY 7 1929

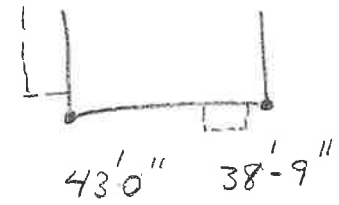

● Curb Box

6" Main

Elev. of Main at tap $4\frac{1}{2}'$

Gate at ●

● Gate at

● Curb Box