

LABOR AND MATERIALS

1	Copper	Connection	$\frac{3}{4}$	\$	
1	Curb	Cock Valve T.S. & V.	$\frac{3}{4}$ in.	\$	
1	Service box	Short $3\frac{1}{2} \times 4\frac{1}{2}$		\$	
	Old returned	Long $4\frac{1}{2} \times 5\frac{1}{2}$		\$	
9	Ft.	Copper Pipe	$\frac{3}{4}$ in.	\$	
	Nipples	in.	at	\$	
	Bushings	to	in. at	\$	
	Red'g			\$	
	Inc'g	Coupl'gs	to in. at	\$	
	Union	in.	at	\$	
	Meter	in.	at	\$	
	Compound Joints	at		\$	
	Maintenance Foreman			\$	
	Hrs. Water Maint. Man	—1 at		\$	
	Hrs. Water Maint. Man	—2 at		\$	
	Hrs. Garage Foreman	at		\$	
	Hrs. Labor	at		\$	
	Hrs. Compressor	at		\$	
	Trucking			\$	
	Pav't Patch			\$	
				\$	
				\$	
ST. CURRAW LANE No. 18-26
 PT. Ave.

Name of Owner

Labor and Mat'l. Report JUNE 23 1925



13-6 21-6
 ● Curb Box

4" Main Elev. of Main at tap 5'

Gate at ● Gate at

● Curb Box


Labor and Materials

1	Copper Lead	Connection $\frac{3}{4}$	\$
1	Curb	Cock Valve T. S. & V. } $\frac{3}{4}$ in	\$
1	Service Box Old returned.	Short 3 1/2 x 4 1/2 Long 4 1/2 x 5 1/2 Buff of Rdway	\$
8	Ft.	3 in. } Copper Galv Iron Cast Iron } Pipe at	\$
	Nipples	in. at	\$
	Bushings	to in. at	\$
	Red'g Inc'g	Conplings to in. at	\$
	Union	in. at	\$
	Meter	in. at	\$
	Lead Joints	at	\$
	Leadite Joints	at	\$
	Hrs. Foreman	at	\$
	Hrs. Chauffeur	at	\$
	Hrs. Tapper	at	\$
	Hrs. Labor	at	\$
	Hrs. Labor	at	\$
	Hrs. Compressor	at	\$
	Compensation Ins.		\$
	Trucking		\$
	Builders Use of Water		\$
			\$
			\$
St. Pl. Ave. No. 18-26
Curren Lane

Name of Owner:
TAP for Express Co.

Labor and Mat'l. Report June 23 1925

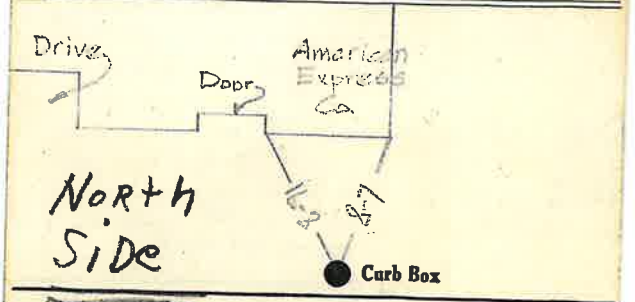

4" Main Elev. of Main at tap 5
Gate at • • Gate at

• Curb Box
TWO
3/4 taps
AT THIS ADDRESS

LABOR AND MATERIALS

1	Copper Lead	} Connection	4" top		\$	
1	Curb	{ Gock Valve F.S. & V.	4" in.		\$ 2.05	
1	Service Box Old returned	{ Short 3"x4" Long 4"x5" Buffer Rdway			\$ 2.75	
216	Ft.	4 in.	{ Copper Galv Iron Cast Iron	Pipe at .65	\$ 13.98	
	Nipples	in.	at		\$	
	Bushings	to	in.	at	\$	
	Red'g Inc'g	Couplings	to	in.	at	\$
	Union	in.	at		\$	
	Meter	in.	at		\$	
5	Lead Joints at	joint 1 lbs			\$ 0.75	
5	Leadite Joints at	1 lb			\$ 1.10	
	Hrs. Foreman at				\$	
16	Hrs. Chauffeur at				\$ 12.-	
6	Hrs. Tapper at				\$ 4.50	
18	Hrs. Labor at				\$ 11.70	
2	Hrs. Labor at	compressor	2.50		\$ 5.-	
2	Hrs. Compressor at		2.75		\$ 1.75	
	Compensation Ins.	29.95	2.50		\$ 90	
✓	Trucking	3 hrs			\$ 3.50	
	Builders Use of Water	Equip	96 L		\$	
	Gas	1 lb			\$ 8.37	
	Oil	1 lb			\$ 1.15	
1	gal. gas				\$ 11	
2	lb. oil				\$ 22	
	2 hrs. labor	2 1/2 M	42.36		\$ 99	
	Del call to Carriage	1.20			\$ 92.87	
					\$ 1.30	
					\$ 94.17	

T.B. 33W

St.
Pl.
Ave. No.

Curtain

Name of Owner
D & H

Labor and Mat'l. Report Dec 20-21 19 25

National Biscuit Co.
18-26

1 Main Elev. of Main at tap 5

Gate at ● ● Gate at

● Curb Box

This Tap For D. & H.
R.R. Water Tank.

4" Top