

LABOR AND MATERIALS

1	Copper Lead	Connection	-----	\$
1	Curb	Cock Valve T. S. & V.	-----	\$
			in.	-----
	Service Box	Short 3 1/2 x 4 1/2 Long 4 1/2 x 5 1/2 Buff. or Rdway	-----	\$
	Old returned		-----	
	"		-----	
22	Ft.	1	in.	Copper Galv Iron Cast Iron
				Pipe at
				\$
	Nipples	in.	at	\$
1	Bushings	to	in.	at
				\$
	Red'g Inc'g	Couplings	to	in.
				\$
	Union	in.	at	\$
	Meter	in.	at	\$
	Lead Joints	at		\$
	Leadite Joints	at		\$
	Hrs. Foreman	at		\$
	Hrs. Chauffeur	at		\$
	Hrs. Tapper	at		\$
	Hrs. Labor	at		\$
	Hrs. Labor	at		\$
	Hrs. Compressor	at		\$
	Compensation Ins.			\$
	Trucking			\$
	Builders Use of Water			\$
				\$
				\$
				\$
				\$

-St.

-Pl.


Darwin

Ave. No. 1

Name of Owner _____

Labor and Mat'l. Report

AUG 15 1924

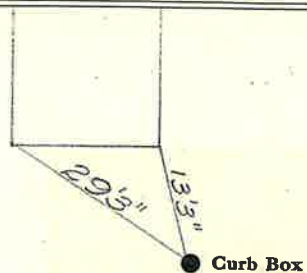

Main	Elev. of Main at tap
Gate at ●	● Gate at

● Curb Box

LABOR AND MATERIALS

Copper } Connection _____ \$ _____
 Lead }
 Curb } Cock _____ in. _____ \$ _____
 } Valve _____
 } T.S. & V. _____
 Service box { Short 3-1/2 x 4-1/2 } _____ \$ _____
 Old returned { Long 4-1/2 x 5-1/2 } _____
~~224~~ 28' 5" 3/4 in. { Copper } Pipe at _____ \$ _____
 Nipples _____ in. at _____ \$ _____
 Bushings _____ to _____ in. at _____ \$ _____
 Red'g _____
 Inc'g _____
 Union _____ in. at _____ \$ _____
 Meter _____ in. at _____ \$ _____
 _____ \$ _____
 Compound Joints at _____ \$ _____
 Maintenance Foreman _____ \$ _____
 Hrs. Water Maint. Man - 1 at _____ \$ _____
 Hrs. Water Maint. Man - 2 at _____ \$ _____
 Hrs. Garage Foreman _____ at _____ \$ _____
 Hrs. Labor _____ at _____ \$ _____
 Hrs. Compressor at _____ \$ _____
 _____ \$ _____
 Trucking _____ \$ _____
 Pav't Patch _____ \$ _____
 _____ \$ _____
 _____ \$ _____
 _____ \$ _____
 _____ \$ _____

DARWIN St
 Ave. No. 1
 Name of Owner
 ODDEY

Labor and Mat'l. Report 2000, NOV. 7



18'2" 25'2"

● Curb Box

4" Main Elev. of Main at tap _____
 Gate at ● Gate at ●

● Curb Box