

LABOR AND MATERIALS


1	Copper Lead	Connection	$\frac{3}{4}$	\$	
1	Curb	Cock Valve T. S. & V.	1" in.	\$	
1	Service box Old returned	Short $3\frac{1}{2} \times 4\frac{1}{2}$ Long $4\frac{1}{2} \times 5\frac{1}{2}$		\$	
16	Ft. 1" in.	Copper G. I. Pipe		\$	
	Nipples	in. at		\$	
1	Bushings	1" to $\frac{1}{2}$ " in. at		\$	
	Red'g Inc'g	Coupl'gs to in. at		\$	
	Union	in. at		\$	
	Meter	in. at		\$	
	Compound Joints	at		\$	
	Maintenance Foreman			\$	
	Hrs. Water Maint. Man-1	at		\$	
	Hrs. Water Maint. Man-2	at		\$	
	Hrs. Garage Foreman	at		\$	
	Hrs. Labor	at		\$	
	Hrs. Compressor	at		\$	
	Trucking			\$	
	Pav't Patch			\$	
				\$	
				\$	
DARWIN

St. Ave. No. 15

Name of Owner

Labor and Mat'l. Report SEPT. 4 1924

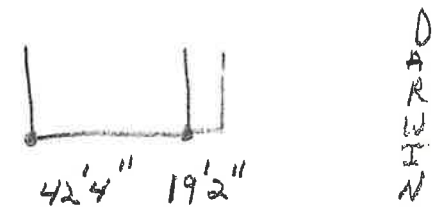

● Curb Box

ORVILLE ST

6" Main Elev. of Main at tap 4'

Gate at ● Gate at

● Curb Box

TAP ON ORVILLE

OLD CON. DUG UP