


LABOR AND MATERIALS

1	Copper Lead	Connection	$\frac{3}{4}$	\$
1	Curb	Cock Valve	$\frac{3}{4}$ in.	\$
		T.S. & W.		
1	Service box	Short	$3\frac{1}{2} \times 4\frac{1}{2}$	\$
	Old returned	Long	$4\frac{1}{2} \times 5\frac{1}{2}$	\$
11	Ft. $\frac{3}{4}$ in.	Copper	Pipe at	\$
		C.P.		
	Nipples	in. at		\$
	Bushings	to in. at		\$
	Red'g			\$
	Inc'g	Coupl'gs to in. at		\$
	Union	in. at		\$
	Meter	in. at		\$
				\$
	Compound Joints	at		\$
	Maintenance Foreman			\$
	Hrs. Water Maint. Man-1	at		\$
	Hrs. Water Maint. Man-2	at		\$
	Hrs. Garage Foreman	at		\$
	Hrs. Labor	at		\$
	Hrs. Compressor	at		\$
				\$
	Trucking			\$
	Pav't Patch			\$
				\$
				\$
St. DAVIS
~~Pl.~~
 Ave. No. 1-3

Name of Owner
STEVENS

Labor and Mat'l. Report OCT. 22. 19 36

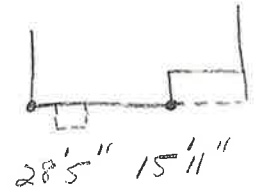

● Curb Box

4 Main Elev. of Main at tap 5'
 Gate at ● ● Gate at

● Curb Box

OLD TAP SHUT OFF