


# LABOR AND MATERIALS

<u>  </u> Copper Lead } Connection _____ \$ _____
<u>  </u> Curb } Cock } Valve } T.S. & V. } _____ in. _____ \$ _____
<u>  </u> Service box { Short 3-1/2 x 4-1/2 } _____ \$ _____ Old returned { Long 4-1/2 x 5-1/2 }
<u>27</u> Ft. <u>3/4"</u> in. <u>Copper</u> } Pipe at _____ \$ _____ } C.I. } C.I.
<u>  </u> Nipples _____ in. at _____ \$ _____
<u>  </u> Bushings _____ to _____ in. at _____ \$ _____
<u>  </u> Red'g _____
<u>  </u> Inc'g _____
<u>  </u> Union _____ in. at _____ \$ _____
<u>  </u> Meter _____ in. at _____ \$ _____
<u>  </u> _____ \$ _____
<u>  </u> Compound Joints at _____ \$ _____
<u>  </u> Maintenance Foreman _____ \$ _____
<u>  </u> Hrs. Water Maint. Man - 1 at _____ \$ _____
<u>  </u> Hrs. Water Maint. Man - 2 at _____ \$ _____
<u>  </u> Hrs. Garage Foreman _____ at _____ \$ _____
<u>  </u> Hrs. Labor _____ at _____ \$ _____
<u>  </u> Hrs. Compressor at _____ \$ _____
<u>  </u> _____ \$ _____
<u>  </u> Trucking _____ \$ _____
<u>  </u> Pav't Patch _____ \$ _____
<u>  </u> _____ \$ _____
<u>  </u> _____ \$ _____
DAVIS St. 22  
Pl.  
 Ave. No.

Name of Owner PACE BUILDERS

Labor and Mat'l. Report ~~40~~ 2005

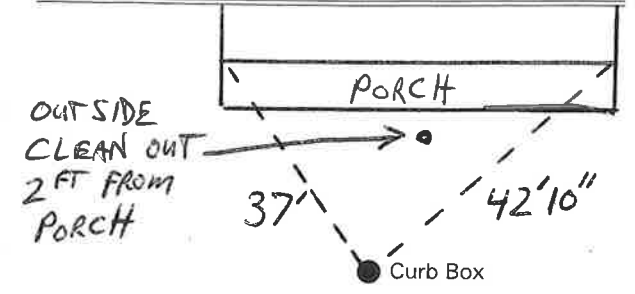

OUTSIDE  
CLEAN OUT  
2 FT FROM  
PORCH

\_\_\_\_\_ Main Elev. of  
Main at tap \_\_\_\_\_  
 Gate at ● ● Gate at

\_\_\_\_\_ ● Curb Box

SEWER MAIN IS 18' FROM  
CURB BOX.

Labor and Materials

1	Copper	Connection	3/4	\$ 1.25
	Lead			
1	Curb	Cock Valve T.S.&V.	3/4 in	\$ 1.70
1	Service Box	Short 3 1/2 x 4 1/2		\$ 1.37
	Old returned	Long 4 1/2 x 5 1/2		
11	Ft. 3/4 in.	Copper Galv. Iron Cast Iron	Pipe at 13/2	\$ 1.49
	Nipples	in. at		\$
1	Bushings	3/4 to 1/2 in. at		\$ .45
	Red'g Inc'g	Couplings	to in. at	\$
	Union	in. at		\$
	Meter	in. at		\$
	Lbs. Br. Stone	at		\$
	Lbs. Sand	at		\$
	Bags Cement	at		\$
	Paving Brick	Mack Red Asphalt	at	\$
	Lead Joints	at		\$
	Leadite Joints	at		\$
3	Hrs. Foreman	at	6.26	\$ 1.88
7	Hrs. Common Labor	at	5.2	\$ 1.57
6	Hrs. Common Labor	at	4.5	\$ 2.70
	Hrs. Mason	at		\$
	Hrs. Masons Helper	at		\$
	Hrs. Compressor	at		\$
	Compensation Ins			\$ .71
	Trucking			\$ 1.00
	Builders Use of Water			\$

Total \$ 12.55

1935-186


# 22

Labor and Material Report

OCT. 4

1935

3/4 tap at 22 Davis st

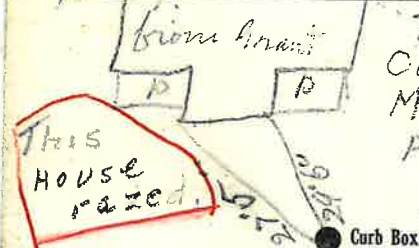

This Curb box Measured From # 24 Davis St.

4" Main HOUSE REPLACED

South Side

Elev. of Main at tap 4 1/2

Gate at

Gate at

Front Ave.

