


LABOR AND MATERIALS

1	Copper	} Connection	_____	\$ _____
1	Lead		_____	\$ _____
1	Curb	} Cock Valve	_____ in.	\$ _____
			T.S. & V.	_____
1	Service box	} Short $3\frac{1}{2} \times 4\frac{1}{2}$	_____	\$ _____
	Old returned		Long $4\frac{1}{2} \times 5\frac{1}{2}$	_____
28	Ft. $\frac{3}{4}$ in.	} Copper	} Pipe at _____	\$ _____
	Nipples	_____ in.	at _____	\$ _____
	Bushings	_____ to _____	in. at _____	\$ _____
	Red'g	} Coupl'gs	_____ to _____	in. at _____
	Inc'g			
	Union	_____ in.	at _____	\$ _____
	Meter	_____ in.	at _____	\$ _____
	Compound Joints	_____ at _____		\$ _____
	Maintenance Foreman	_____ at _____		\$ _____
	Hrs. Water Maint. Man—1	_____ at _____		\$ _____
	Hrs. Water Maint. Man—2	_____ at _____		\$ _____
	Hrs. Garage Foreman	_____ at _____		\$ _____
	Hrs. Labor—	_____ at _____		\$ _____
	Hrs. Compressor	_____ at _____		\$ _____
	Trucking	_____ at _____		\$ _____
	Pav't Patch	_____ at _____		\$ _____
				\$ _____
				\$ _____
St. DAVIS No. 24
 Name of Owner _____

Labor and Mat'l. Report JULY 9 1934

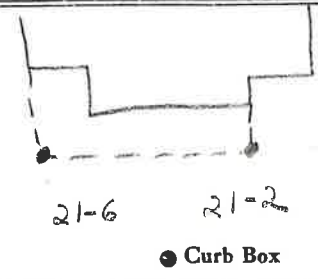

4" Main Elev. of Main at tap 6'
 Gate at • • Gate at

• Curb Box
 OLD TAP TO BE SHUT OFF