

LABOR AND MATERIALS

1	Copper	} Connection $\frac{3}{4}$ "	\$
	Lead		
1	Curb	} Cock Valve } 1" in.	\$
			T.S. & V.
1	Service box	{ Short $3\frac{1}{2}$ x $4\frac{1}{2}$ } Old returned { Long $4\frac{1}{2}$ x $5\frac{1}{2}$ }	\$
26	Ft. / in.		{ Copper } { G.I. } { G.I. }
	Nipples	in. at	\$
	Bushings	to in. at	\$
	Red'g	} Coupl'gs to in. at	\$
	Inc'g		
	Union	in. at	\$
	Meter	in. at	\$
			\$
	Compound Joints	at	\$
	Maintenance Foreman		\$
	Hrs. Water Maint. Man-1	at	\$
	Hrs. Water Maint. Man-2	at	\$
	Hrs. Garage Foreman	at	\$
	Hrs. Labor	at	\$
	Hrs. Compressor	at	\$
			\$
	Trucking		\$
	Pav't Patch		\$
			\$
			\$
			\$
			\$

DAVIS


St. ~~121.~~  
Ass. No. 26

Name of Owner

TAX ID # 302.19-11-3

Labor and Mat'l. Report

MAY 16 1924

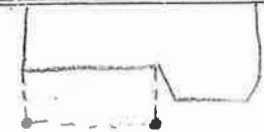

32'8" 24'8"

● Curb Box

4" Main

Elev. of Main at tap 5-1/2'

Gate at ●

● Gate at

● Curb Box