


LABOR AND MATERIALS

1	Copper	} Connection <u>3/4"</u>	\$	
	Lead			
1	Curb	} <u>3/4 in.</u> (MARKED ORISEMI)	\$	
	Cook Valve			
	T. S. & V.			
1	Service box	} Short <u>3 1/2 x 4 1/2</u>	\$	
	Old returned			Long <u>4 1/2 x 5 1/2</u>
				Buf. or Rdway
9	Ft. <u>3/4 in.</u>	} Copper	\$	
				Iron
		Pipe at	\$	
	Nipples	in. at	\$	
	Bushings	to in. at	\$	
	Red'g	} Coupl'gs. to in. at	\$	
	Inc'g			
	Union	in. at	\$	
	Meter	in. at	\$	
	Lead Joints at		\$	
	Compound Joints at		\$	
	Maintenance Foreman		\$	
	Hrs. Water Maint. Man-1 at		\$	
	Hrs. Water Maint. Man-2 at		\$	
	Hrs. Garage Foreman at		\$	
	Hrs. Labor at		\$	
	Hrs. Compressor at		\$	
	Compensation Ins. at \$	per C	\$	
	Trucking		\$	
	Pav't Patch		\$	
	<u>TAP MADE BY PECK & CO.</u>			
	O'head	<u>April-13-1973</u>	\$	
			\$	
			\$	

DAVIS St. No. 27

Name of Owner NOONE

Labor and Mat'l. Report April 13 1973

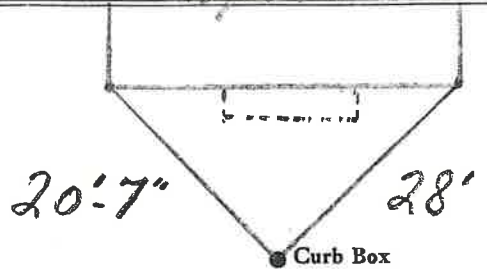

4" Main Elev. of Main at tap 5'

Gate at • Gate at

• Curb Box