


LABOR AND MATERIALS

1	Copper Lead	Connection	3/4"	\$
1	Curb	Cock Valve T.S. & V.	3/4" in.	\$
	Service box	Short 3 1/2 x 4 1/2 Long 4 1/2 x 5 1/2		
	Old returned			
8	Ft.	Copper	3/4" in.	Pipe at \$
	Nipples		in. at	\$
	Bushings		to in. at	\$
	Red'g Inc'g	Coupl'gs	to in. at	\$
	Union		in. at	\$
	Meter		in. at	\$
	Compound Joints		at	\$
	Maintenance Foreman			\$
	Hrs. Water Maint. Man	1 at		\$
	Hrs. Water Maint. Man	2 at		\$
	Hrs. Garage Foreman	at		\$
	Hrs. Labor	at		\$
	Hrs. Compressor	at		\$
	Trucking			\$
	Pav't Patch			\$
				\$
				\$
St. DAVIS No. 29

Name of Owner MAHONEY

Labor and Mat'l. Report OCT 15 19 36

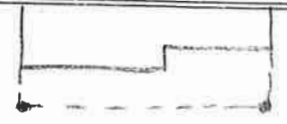

20' 30' 10"

● Curb Box

4" Main Elev. of Main at tap 5'

Gate at ● Gate at

TAX ID # 302.15-14-18

● Curb Box

OLD TAP SHUT OFF