


LABOR AND MATERIALS

1	Copper	} Connection	$\frac{3}{4}$ "	\$
	Lead		$\frac{3}{4}$ "	
1	Curb	} Cock Valve T.S. & V.	$\frac{3}{4}$ " in.	\$
1	Service box	} Short $3\frac{1}{2}$ x $4\frac{1}{2}$ Long $4\frac{1}{2}$ x $5\frac{1}{2}$		\$
	Old returned			
24	Ft. $\frac{3}{4}$ "	} Copper G.I. G.I.	Pipe at	\$
	Nipples	in. at		\$
	Bushings	to in. at		\$
	Red'g Inc'g	} Coupl'gs	to in. at	\$
	Union	in. at		\$
	Meter	in. at		\$
				\$
	Compound Joints	at		\$
	Maintenance Foreman			\$
	Hrs. Water Maint. Man-1	at		\$
	Hrs. Water Maint. Man-2	at		\$
	Hrs. Garage Foreman	at		\$
	Hrs. Labor	at		\$
	Hrs. Compressor	at		\$
				\$
	Trucking			\$
	Pav't Patch			\$
				\$
				\$
				\$
				\$

St. DAVIS Ave. No. 30

Name of Owner WHITE

Labor and Mat'l. Report OCT. 15 19 36

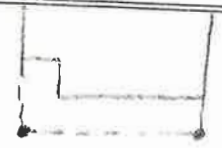

27' 20'

● Curb Box

4" Main Elev. of Main at tap 5'

Gate at ● Gate at

TAX ID # 302.19-11-5

● Curb Box

OLD TAP SHUT OFF