


LABOR AND MATERIALS

1 Copper } Connection $\frac{3}{4}$ \$ _____
~~Lead~~
 1 Curb } Cock } $\frac{3}{4}$ in. \$ _____
 } Valve }
 } Drive v. }
 1 Service box } { Short $2\frac{1}{2}$ x $4\frac{1}{2}$ }
 Old returned } { Long $4\frac{1}{2}$ x $5\frac{1}{2}$ } \$ _____
 24 Ft. $\frac{3}{4}$ in. } { Copper } Pipe at \$ _____
 } { Galv. }
 } { Galv. }
 Nipples in. at \$ _____
 Bushings to in. at \$ _____
 Red'g }
 Inc'g } Coupl'gs to in. at \$ _____
 Union in. at \$ _____
 Meter in. at \$ _____
 \$ _____
 Compound Joints at \$ _____
 Maintenance Foreman \$ _____
 Hrs. Water Maint. Man—1 at \$ _____
 Hrs. Water Maint. Man—2 at \$ _____
 Hrs. Garage Foreman at \$ _____
 Hrs. Labor— at \$ _____
 Hrs. Compressor at \$ _____
 \$ _____
 Trucking \$ _____
 Pav't Patch \$ _____
 \$ _____
 \$ _____
St. ~~PA~~ No. 4
 DAVIES

Name of Owner
 SEARLES

Labor and Mat'l. Report OCT. 22 1936

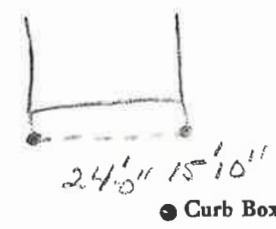

4" Main Elev. of Main at tap 5'

Gate at ● Gate at
 24' to MAIN

● Curb Box

OLD TAP SHUT OFF

TAX ID # 302.19-20-1