

LABOR AND MATERIALS

1	Copper Lead	} Connection	$\frac{3}{4}$ "		\$
1	Curb	} Cock Valve T. S. & V.	$\frac{3}{4}$ " in.		\$
1	Service box Old returned	} Short $3\frac{1}{2}$ x $4\frac{1}{2}$ Long $4\frac{1}{2}$ x $5\frac{1}{2}$			\$
11	Ft. $\frac{3}{4}$ in.	} Copper Pipe			\$
	Nipples	in. at			\$
	Bushings	to in. at			\$
	Red'g Inc'g	Coupl'gs to in. at			\$
	Union	in. at			\$
	Meter	in. at			\$
	Compound Joints	at			\$
	Maintenance Foreman				\$
	Hrs. Water Maint. Man-1	at			\$
	Hrs. Water Maint. Man-2	at			\$
	Hrs. Garage Foreman	at			\$
	Hrs. Labor	at			\$
	Hrs. Compressor	at			\$
	Trucking				\$
	Pav't Patch				\$
					\$
					\$

DAVIS

St.
E.
Ave. No. 33

Name of Owner

Labor and Mat'l. Report

OCT. 14 1936

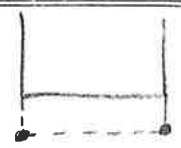

27' 11" 18' 7"

● Curb Box

4" Main

Elev. of
Main at tap 5'

Gate at ●

● Gate at

● Curb Box

LABOR AND MATERIALS


_____ Copper } Connection _____ \$ _____
 _____ Lead }
 _____ Curb } Cock } _____ in. _____ \$ _____
 _____ Valve }
 _____ T.S. & V. }
 _____ Service box { Short 3-1/2 x 4-1/2 } _____ \$ _____
 _____ Old returned { Long 4-1/2 x 5-1/2 }
 _____ Ft. _____ in. { Copper } Pipe at _____ \$ _____
 _____ G.I.
 _____ C.I.
 _____ Nipples _____ in. at _____ \$ _____
 _____ Bushings _____ to _____ in. at _____ \$ _____
 _____ Red'g _____
 _____ Inc'g _____
 _____ Union _____ in. at _____ \$ _____
 _____ Meter _____ in. at _____ \$ _____
 _____ \$ _____
 _____ Compound Joints at _____ \$ _____
 _____ Maintenance Foreman _____ \$ _____
 _____ Hrs. Water Maint. Man - 1 at _____ \$ _____
 _____ Hrs. Water Maint. Man - 2 at _____ \$ _____
 _____ Hrs. Garage Foreman _____ at _____ \$ _____
 _____ Hrs. Labor _____ at _____ \$ _____
 _____ Hrs. Compressor at _____ \$ _____
 _____ \$ _____
 _____ Trucking _____ \$ _____
 _____ Pav't Patch _____ \$ _____
 _____ \$ _____
 _____ \$ _____
DAVIS

St. _____
 Pl. _____
 Ave. No. 33

Name of Owner _____

Labor and Mat'l. Report 19 _____

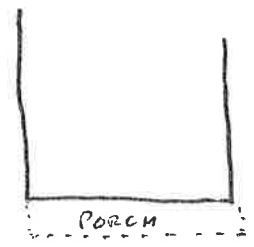

● Curb Box
 CLEANOUT

_____ Main Elev. of Main at tap _____

Gate at ● ● Gate at

● Curb Box